



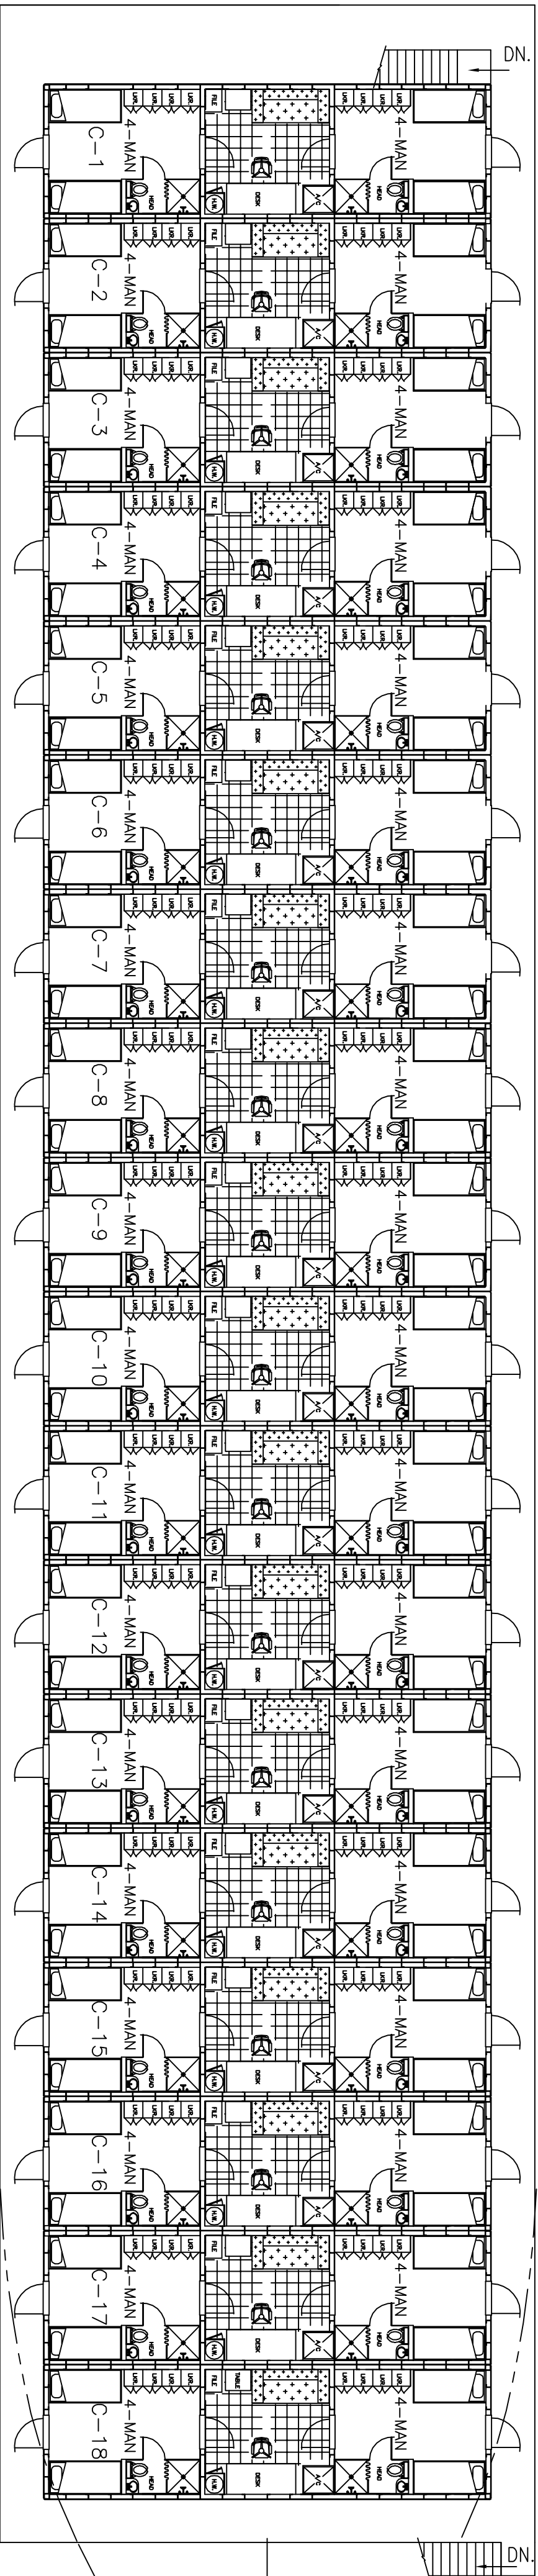


THIRD TIER

PROTRUDING WALKWAYS TO BE INSTALLED UPON VESSEL'S ARRIVAL AT MOORING BERTH.

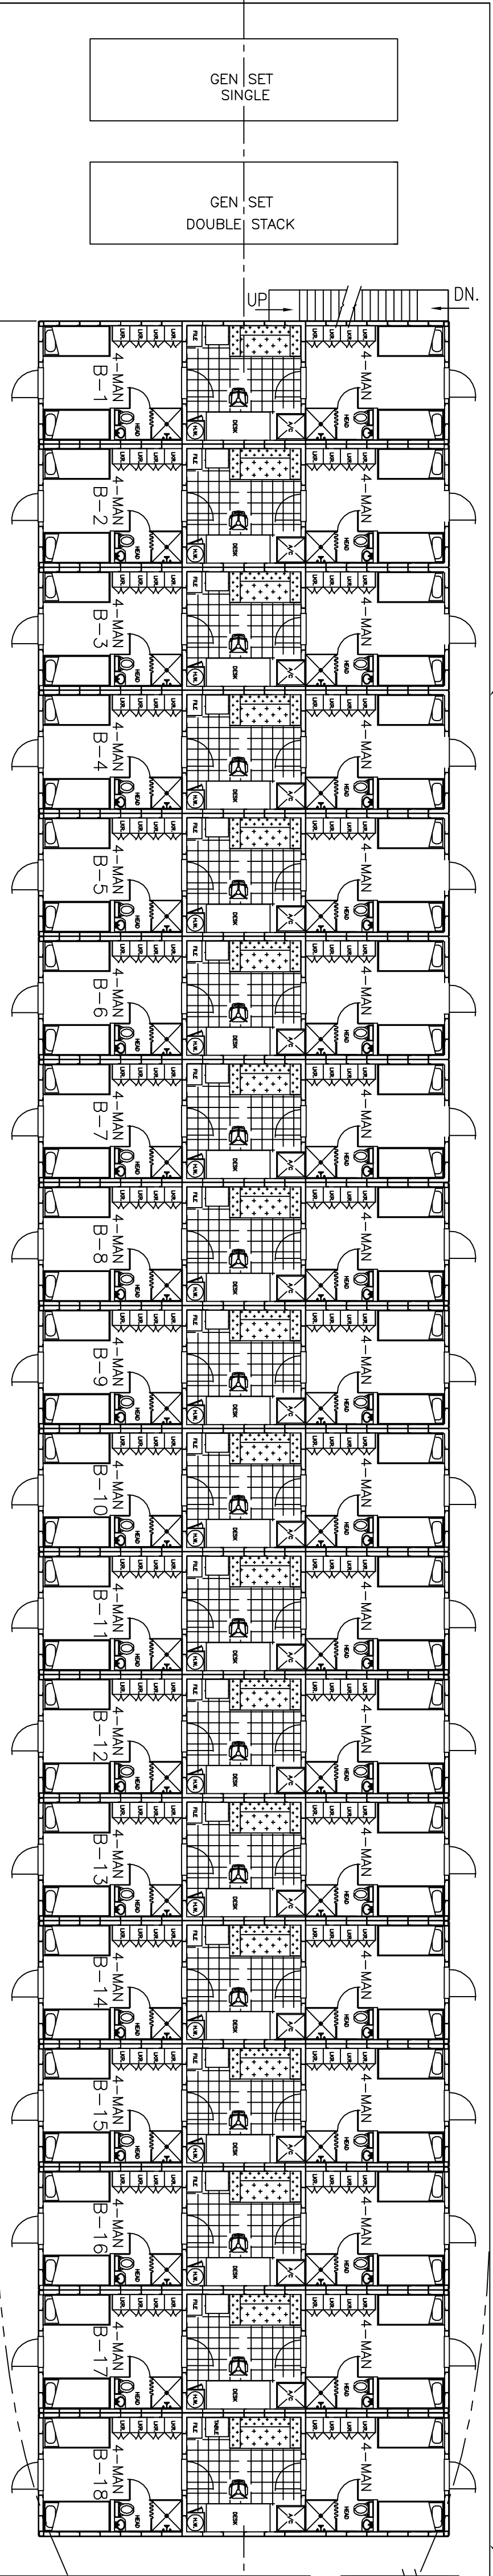

SECOND TIER

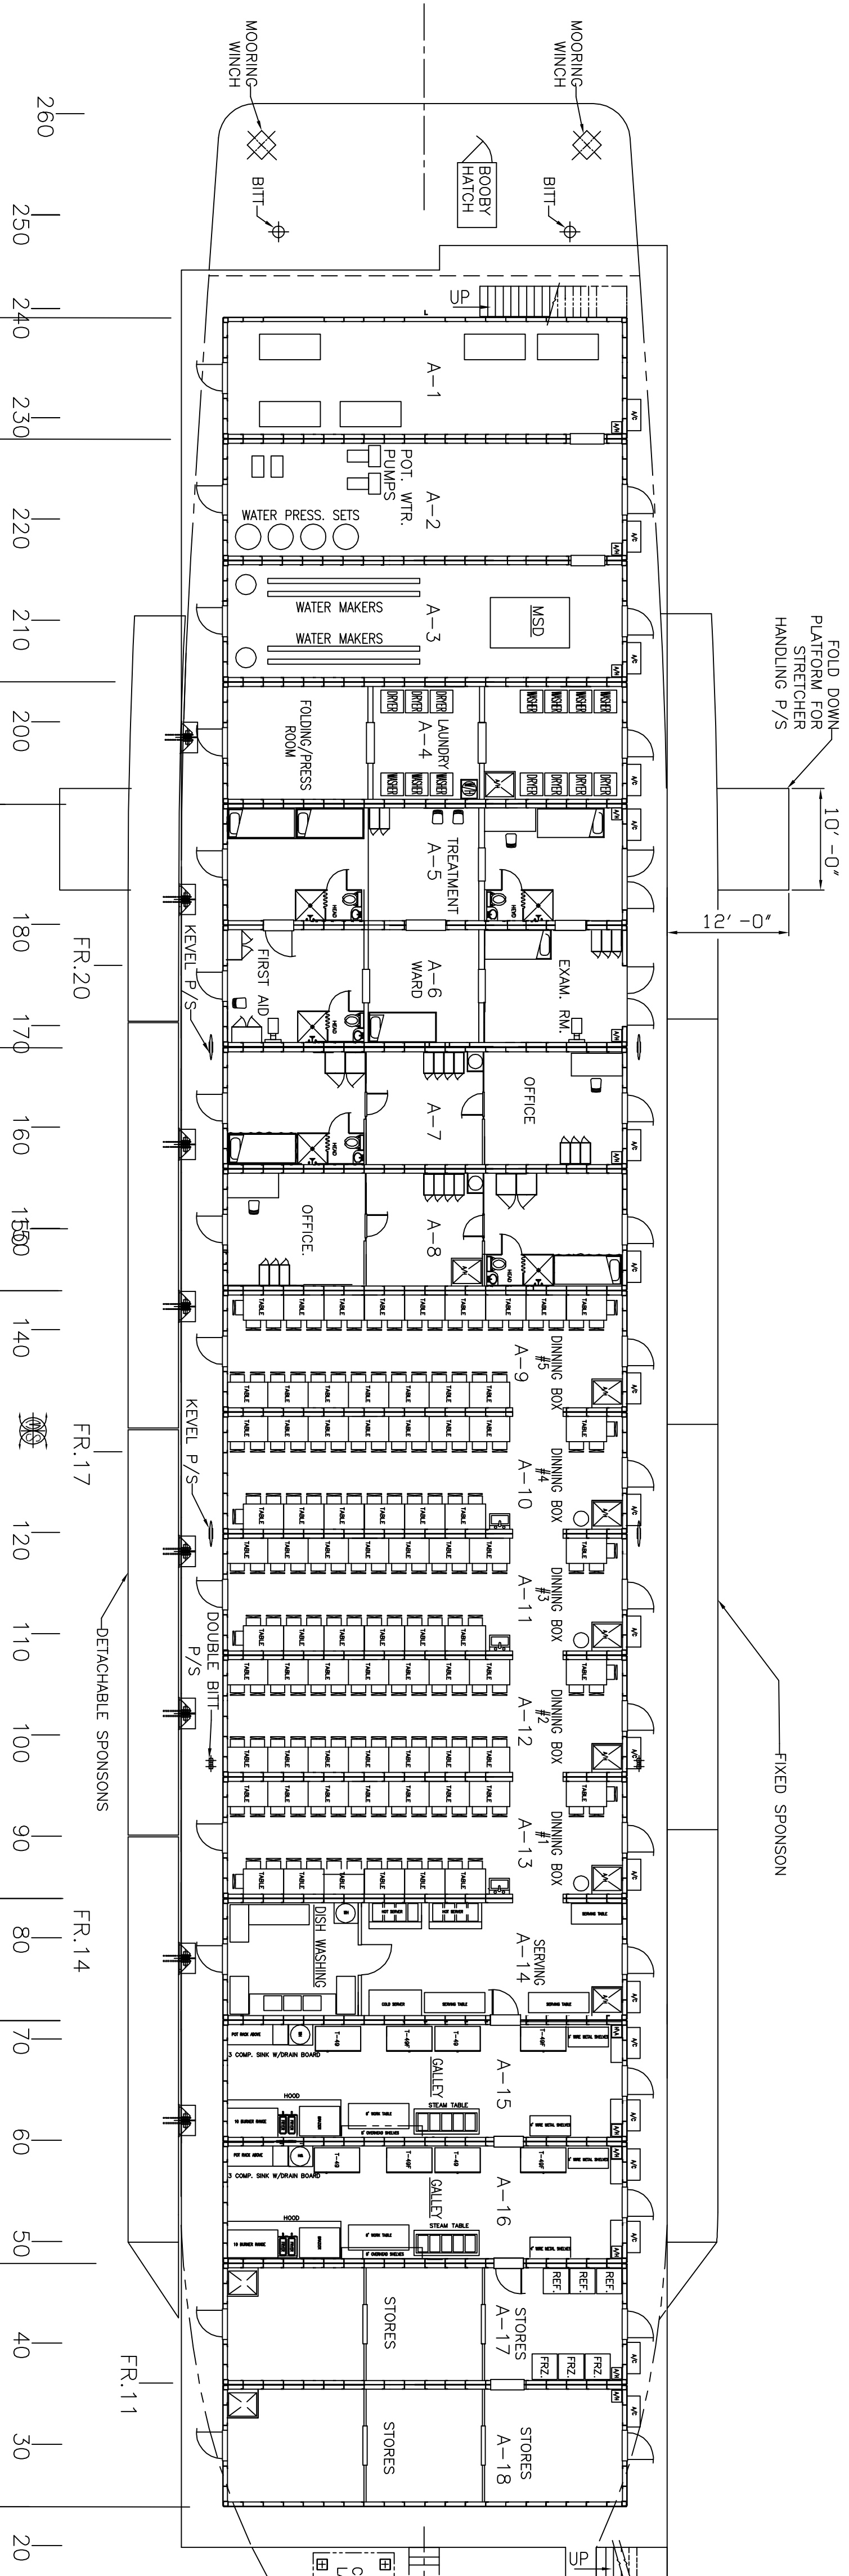

FIRST TIER- MAN DECK

GENERAL NOTES

- 1) THIS DRAWING IS CONCEPTUAL AND DEPICTS MODIFICATIONS TO THE QUARTERBOAT JMC-24. JMC-44
- 2) HANDRAILS, WALKWAYS & STAIRS TO BE PROVIDED BY BUILDER.

Δ	INCORPORATED AS BUILTS	5-01-09	J.G.R.
Δ	MODULES MOVED INTO 5'-0" & DETACHABLE SPONSONS SHOWN	5-26-09	J.G.R.
Δ	MODIFIED LAUNDRY MODULE A-4, RELOCATED FWD CRANE	5-06-09	J.G.R.
Δ	& ADDED FWD CONTAINER LAY-DOWN AREA	2-23-09	J.G.R.
Δ	MODIFIED MISS AND SERVING AREA	1-17-09	J.G.R.
Δ	MODIFIED ARRANGEMENT	11-03-08	J.G.R.
Δ	MODIFIED ARRANGEMENT AND ADDED MODULE NUMBERS	10-16-08	J.G.R.
Δ	MODIFIED ARRANGEMENT AS PER CUSTOMER REQUEST	9-25-08	J.G.R.
Δ	CHANGED MODULE WIDTH TO 4'-0"	9-24-08	J.G.R.
Δ	ADDED PEDISTAL CRANE	9-18-08	J.G.R.
Δ	CHANGED MODULE WIDTH TO 3'-0"		
REV.	DESCRIPTION	DATE	BY

LEARY ENGINEERING, INC.

NEW ORLEANS, LA.

CASHMAN EQUIPMENT CORP.

261' x 48' x 15' QUARTERS BARGE

GENERAL ARRANGEMENT

COPYRIGHT © 2009 LEARY ENGINEERING	DWG. NO. 1289-01
DRAWN BY: J. G. R.	DATE: 8-22-08
SCALE: 3/32" = 1'-0"	SHEET: 1 OF 1
APPROVED BY:	REVISION 11